



Gudangaay Tlaats'gaa Naay - Preliminary Phasing Plan

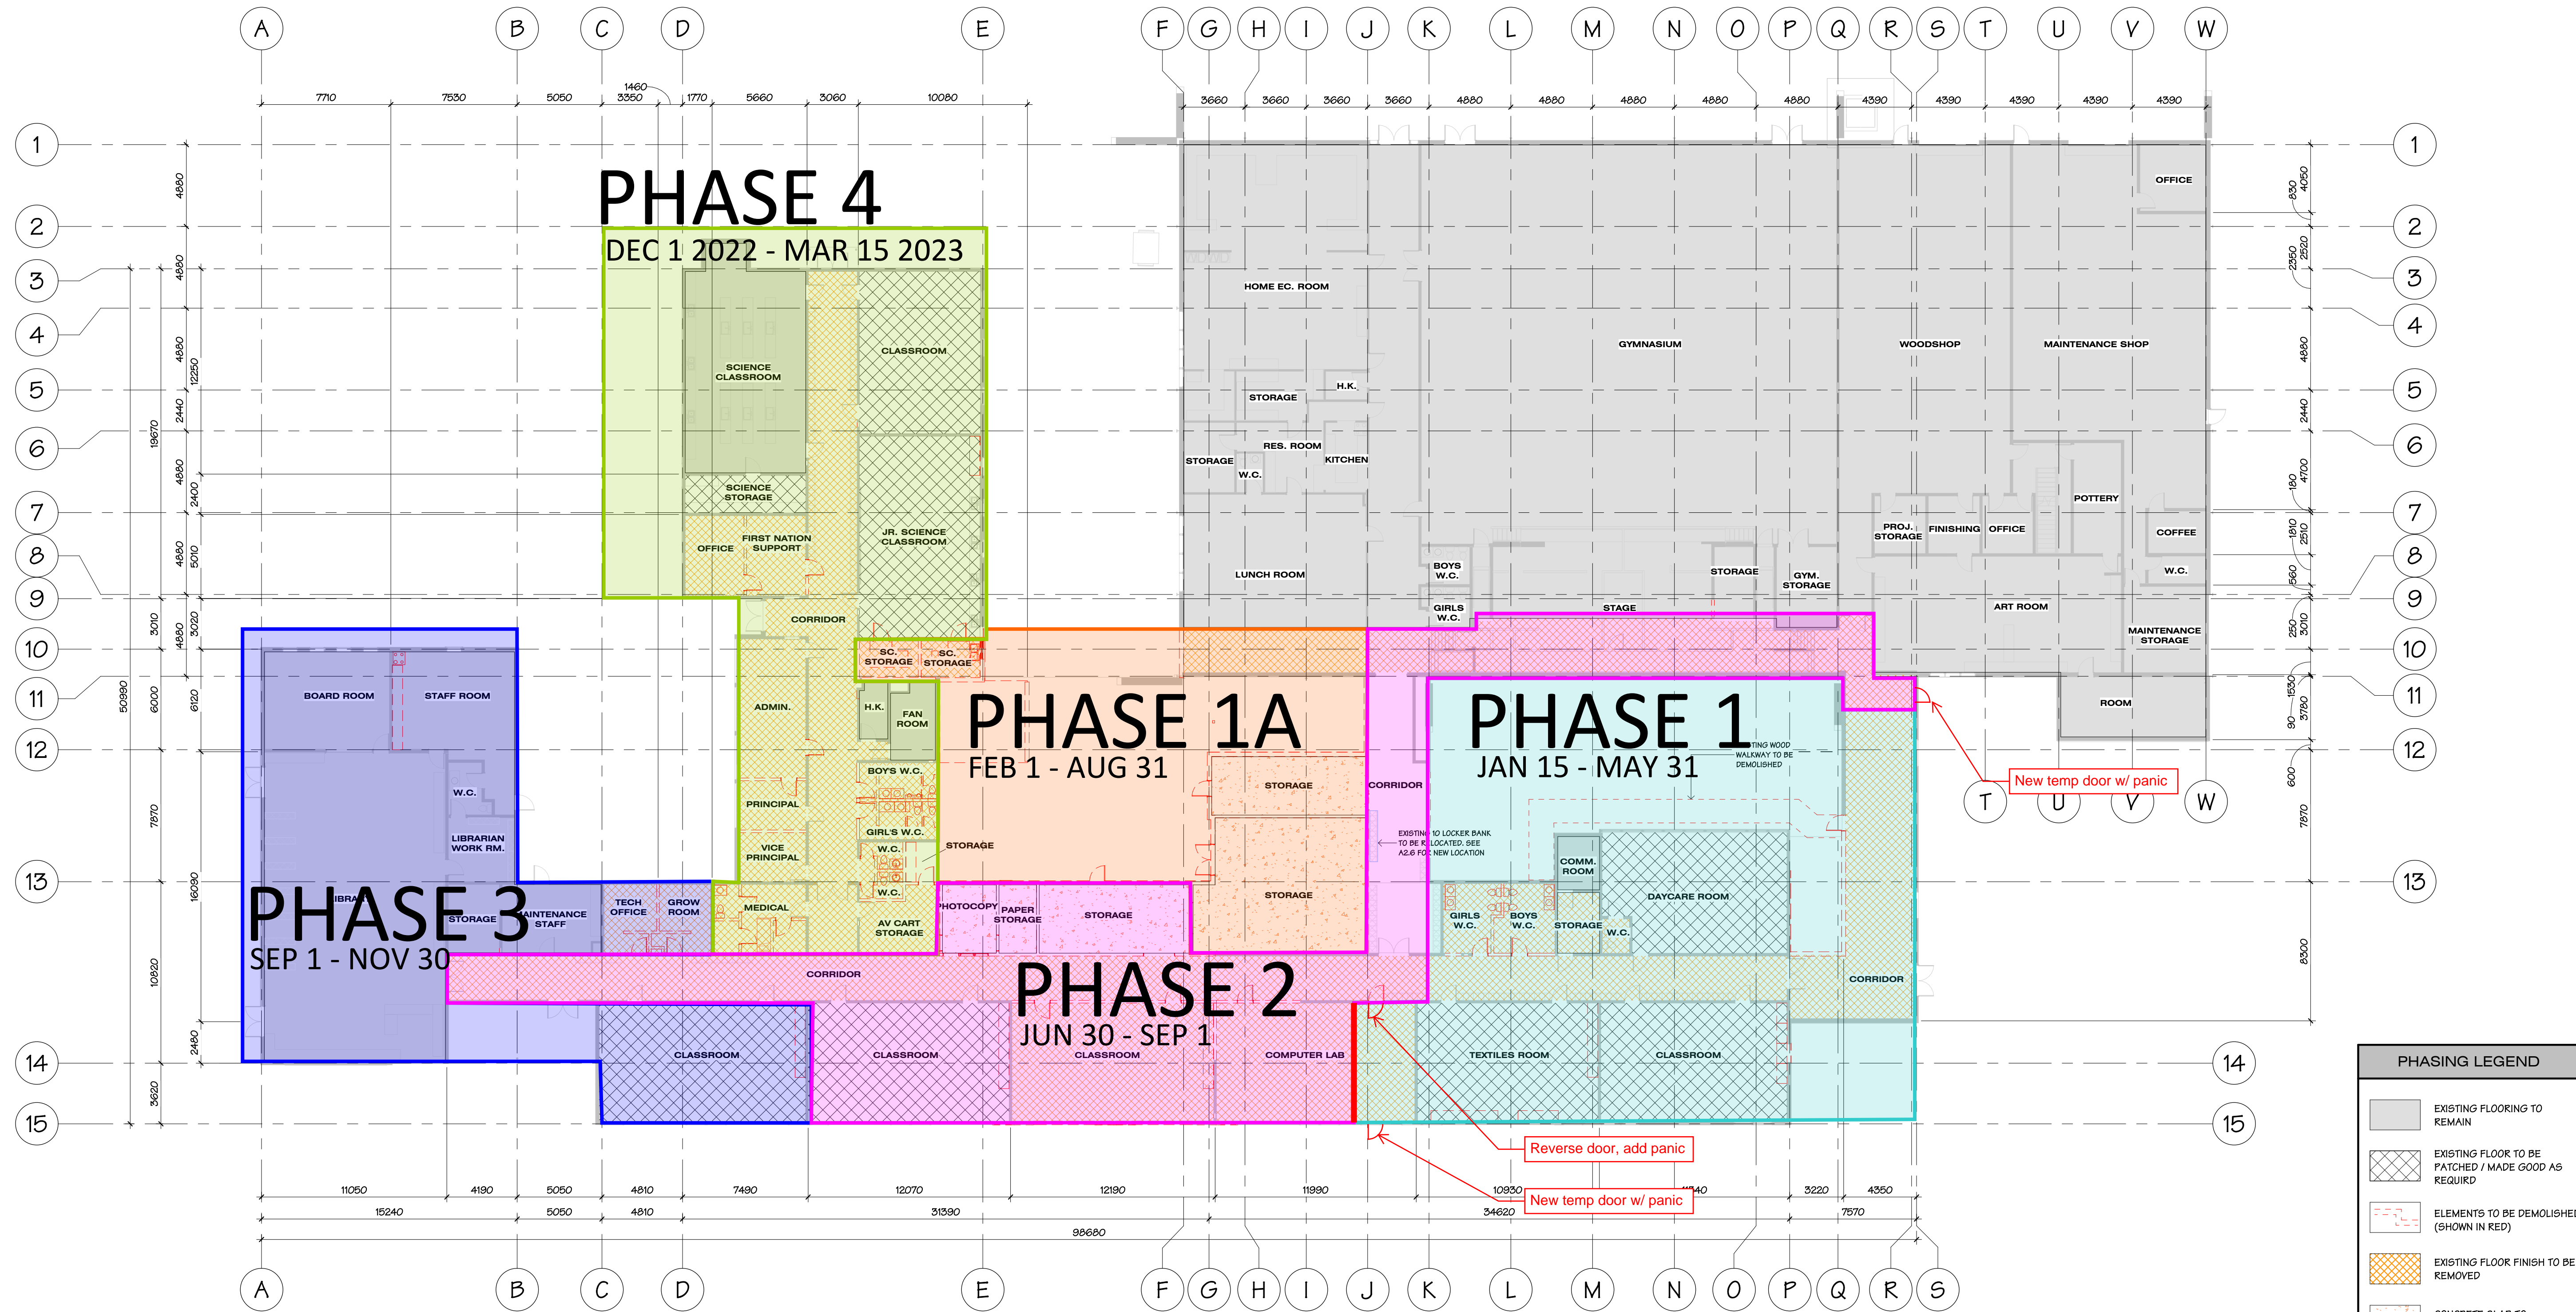

OVERALL FIRST FLOOR DEMO PLAN
1 : 200

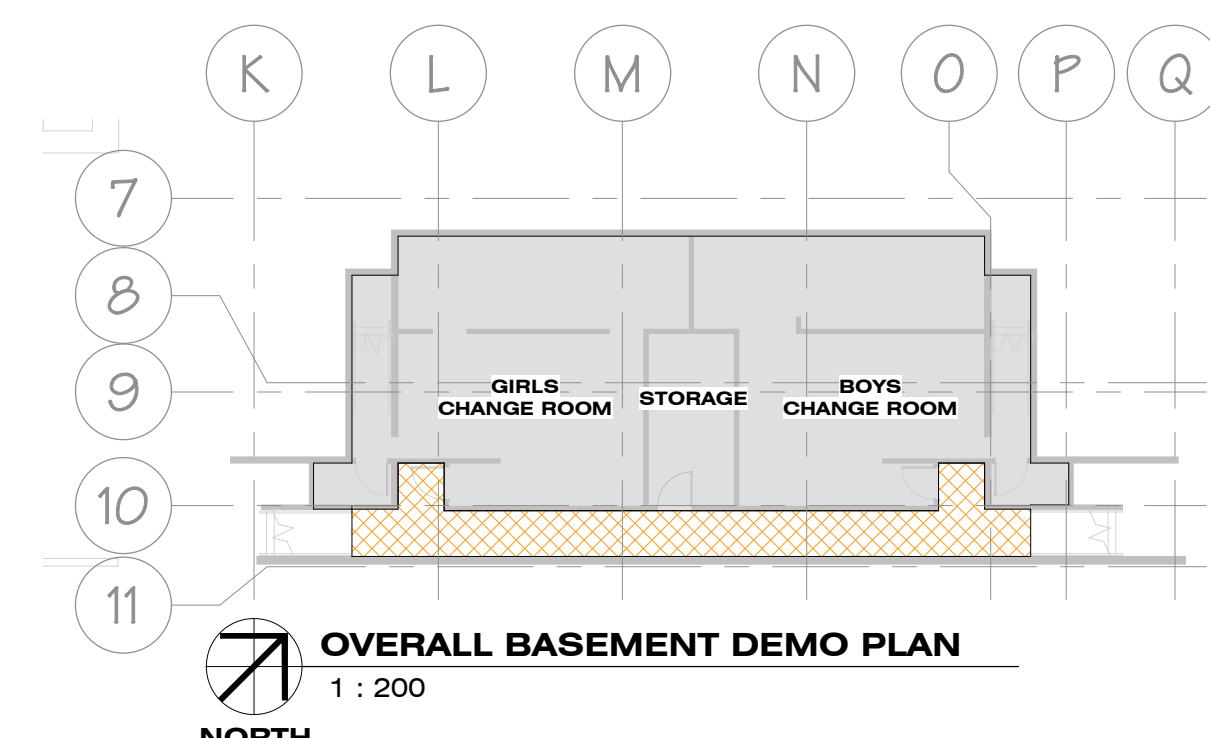


PHASING LEGEND	
[Solid Grey]	EXISTING FLOORING TO REMAIN
[Cross-hatched]	EXISTING FLOOR TO BE PATCHED / MADE GOOD AS REQUIRED
[Red Dashed]	ELEMENTS TO BE DEMOLISHED (SHOWN IN RED)
[Orange Hatched]	EXISTING FLOOR FINISH TO BE REMOVED
[Red Dotted]	CONCRETE SLAB TO BE DEMOLISHED

SYMBOL LEGEND	
1	GRID REFERENCE
Room name 101	ROOM MARKER
10	SECTION MARKER
OO	DETAIL MARKER
10 A101	EXTERIOR ELEVATION MARKER
10 A101	INTERIOR ELEVATION MARKER
101	DOOR MARKER
101	WINDOW MARKERS
101	WALL MARKERS
101	MISC. SYMBOLS

Tsunami Tower Construction
 Concrete - April 15 - Sep 8
 Steel - Jul 1 - Aug 8

station one architects 604 793 9445 Chilliwack 9355 Young Rd V2P 4S3 Abbotsford 203-2190 W. Railway St V2S 2E2

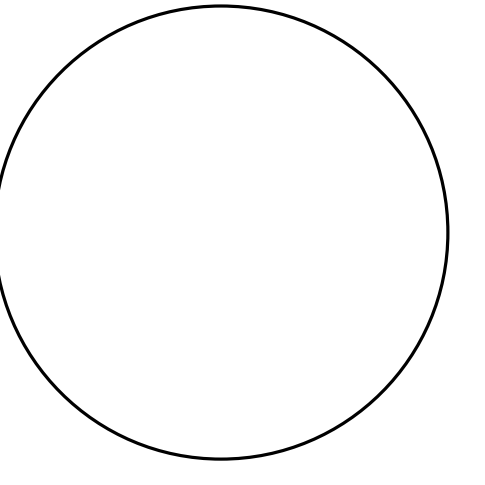

DRAWING NAME
GUDANGAAY TLAATS'GAA NAAI SEISMIC UPGRADE AND SCHOOL AMALGAMATION
 1647 Cook Street, Masset, B.C.

NO.	DATE	DESCRIPTION
1	2021.09.17	Issued for 90% Tender Review
2	2021.11.19	Issued for Tender

OVERALL DEMO PLAN	
JOB NO.	21024
SCALE	As indicated
DATE	2021.09.28

DRAWING NAME
A2.1