School District 50 (Haida Gwaii)

MASSET SCHOOLS Project Updates

	Update Description	Date
1.	Project Start (ESTIMATED)	February 7, 2022
2.	Regular Board Meeting Update	February 28, 2022
3.	Monthly Project Update # 1	March 1, 2022
4.	Monthly Project Update # 2	April 5, 2022
5.	Regular Board Meeting Update	April 12, 2022
6.	Monthly Project Update # 3	May 3, 2022
7.	Regular Board Meeting Update	May 24, 2022
8.	Monthly Project Update # 4	June 7, 2022
9.	Regular Board Meeting Update	June 14, 2022
PHASE 1 ESTIMATED COMPLETION DATE (JAN TO JUNE)		June 30, 2022
10.	Monthly Project Update # 5	July 5, 2022
11.	Monthly Project Update # 6	August 2, 2022
12.	Monthly Project Update # 7	September 6, 2022
13.	Regular Board Meeting Update	September 2022
PHASE 1A ESTIMATED COMPLETION DATE (FEB TO SEPT)		September 30, 2022
PHASE 2 ESTIMATED COMPLETION DATE (JUNE TO OCT)		October 1, 2022
14.	Monthly Project Update # 8	October 4, 2022
TSUNAMI TOWER COMPLETION (APR TO OCT)		October 8, 2022
15.	Regular Board Meeting Update	October 2022
16.	Monthly Project Update # 9	November 1, 2022
PHASE 3 ESTIMATED COMPLETION DATE (SEPT TO DEC)		December 30, 2022
17.	Monthly Project Update # 10	December 6, 2022
18.	Regular Board Meeting Update	December 2022
19.	Monthly Project Update # 11	January 10, 2023
20.	Regular Board Meeting Update	January 2023
21.	Monthly Project Update # 12	February 7, 2023
22.	Regular Board Meeting Update	February 2023
23.	Monthly Project Update # 13	March 7, 2023
PHASE 4 ESTIMATED COMPLETION DATE (DEC TO MAR)		March 15, 2023
24.	Monthly Project Update # 14	April 4, 2023
25.	Regular Board Meeting Update	April 2023

Gudangaay Tlaats'gaa Naay - Preliminary Phasing Plan

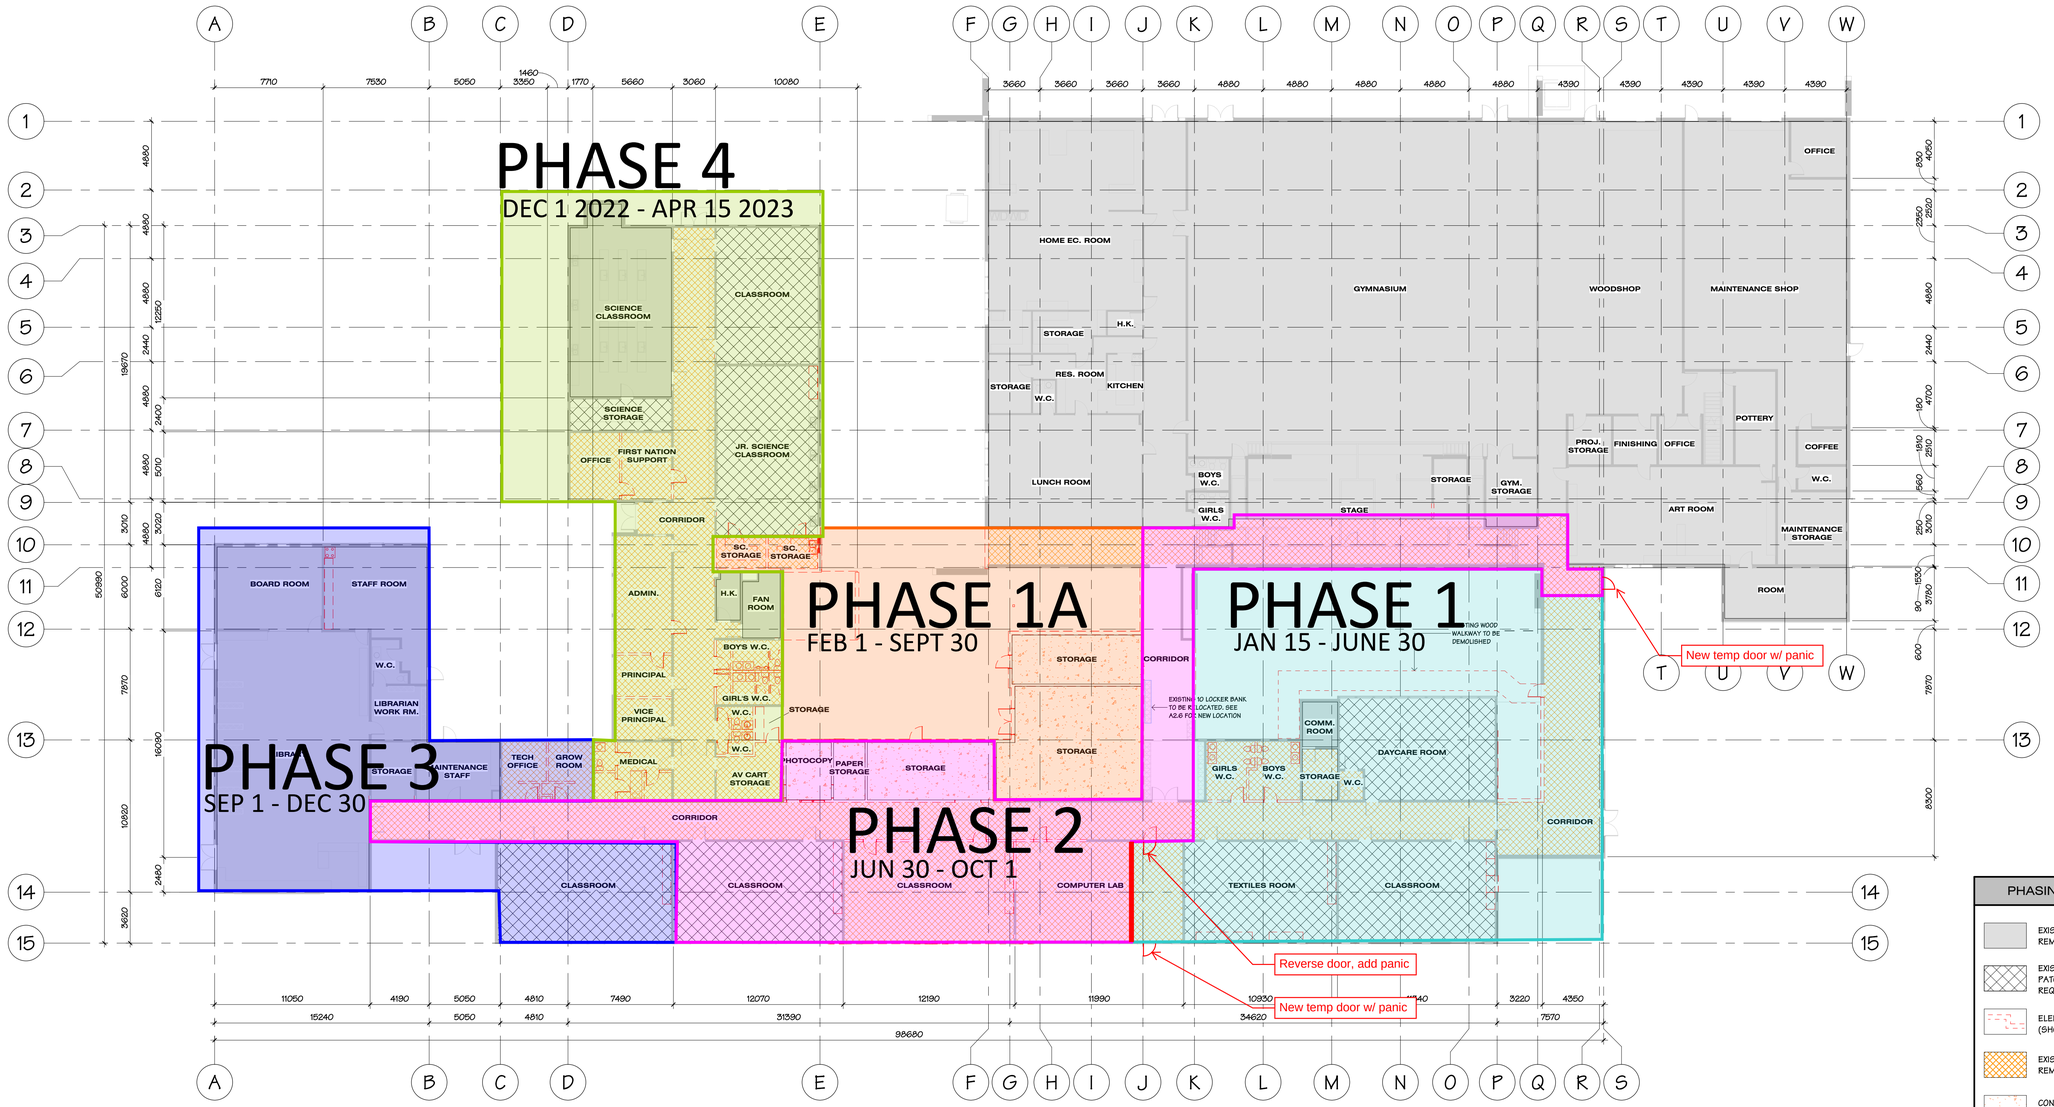

OVERALL FIRST FLOOR DEMO PLAN
1 : 200
NORTH

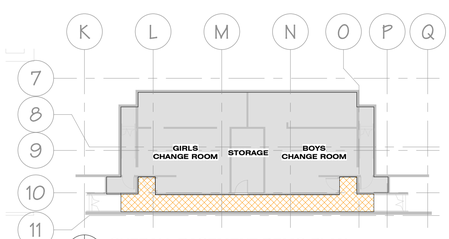

OVERALL BASEMENT DEMO PLAN
1 : 200
NORTH

Tsunami Tower Construction

Concrete - April 15 - Oct 8

Steel - Jul 1 - Sept 8

PHASING LEGEND

- EXISTING FLOORING TO REMAIN
- EXISTING FLOOR TO BE PATCHED / MADE GOOD AS REQUIRD
- ELEMENTS TO BE DEMOLISHED (SHOWN IN RED)
- EXISTING FLOOR FINISH TO BE REMOVED
- CONCRETE SLAB TO BE DEMOLISHED

SYMBOL LEGEND

- GRID REFERENCE
- ROOM MARKER (ROOM NAME / ROOM NUMBER)
- SECTION MARKER (SECTION NUMBER / SHEET NUMBER)
- DETAIL MARKER (DETAIL NUMBER / SHEET NUMBER)
- EXTERIOR ELEVATION MARKER (ELEVATION NUMBER / SHEET NUMBER)
- INTERIOR ELEVATION MARKER (ELEVATION NUMBER / SHEET NUMBER)
- DOOR MARKER (ELEVATION NUMBER / SHEET NUMBER)
- WINDOW MARKERS (ALUMINUM WINDOW / STEEL WINDOW)
- WALL MARKERS (NOMINAL FRAMING THICKNESS / WALL TYPE)
- MISC. SYMBOLS: HB HOSE BIB; F.E.-E FIRE EXTINGUISHER - EXISTING; F.E.-N FIRE EXTINGUISHER - NEW; HD HAND DRYER; CG CORNER GUARD; RWL RAIN WATER LEADER

station one architects
Chilliwack 9355 Young Rd V2P 4S3 604 793 9445
Abbotsford 203-2190 W. Railway St V2S 2E2
soarchitects.com

DRAWING NAME: GUDANGAAY TLAATS'GAA NAAY SEISMIC UPGRADE AND SCHOOL AMALGAMATION

1647 Cook Street, Masset, B.C.

REVISIONS

NO.	DATE	DESCRIPTION
1	2021.09.17	Issued for 90% Tender Review
2	2021.11.19	Issued for Tender

DRAWING NAME: OVERALL DEMO PLAN

JOB NO. 21024 | SCALE As indicated | DATE 2021.09.28

IT IS THE USER'S RESPONSIBILITY TO ENSURE THAT THE DRAWINGS USED ARE THE LATEST ISSUED AND CONFORMED FOR CONSTRUCTION DRAWINGS AND THAT THESE DOCUMENTS ARE OF THE MOST RECENT ISSUE. SOA ASSUMES NO RESPONSIBILITY FOR THE USE OF OUTDATED DRAWINGS OR DOCUMENTS.
COPYRIGHT RESERVED. THESE DRAWINGS AND REMARKS AT ALL TIMES EXCLUSIVE PROPERTY OF THE ARCHITECT AND MAY NOT BE REPRODUCED, PUBLISHED OR USED IN ANY WAY WITHOUT THE EXPRESS PERMISSION OF SOA

A2.1